


DOOR SCHEDULE				
TYPE MARK	WIDTH	HEIGHT	SILL HEIGHT	LINTEL HEIGHT
D1	900	2100	0	2100
D2	1000	2100	0	2100
D3	750	2100	0	2100
D4	1200	2700	0	2700
D5	1500	2700	0	2700
D6	1050	2100	0	2100
FD1	900	1600	500	2100
FD2	700	1600	500	2100

WINDOW SCHEDULE				
TYPE MARK	WIDTH	HEIGHT	SILL HEIGHT	LINTEL HEIGHT
W1	900	750	2700	3450
W2	900	1950	750	2700
W2a	900	1950	150	2100
W3	1800	900	1000	1900
W4	750	1950	750	2700
W5	750	1500	1200	2700

JE ✓
 JD ✓
 ATP ✓
 DTP ✓

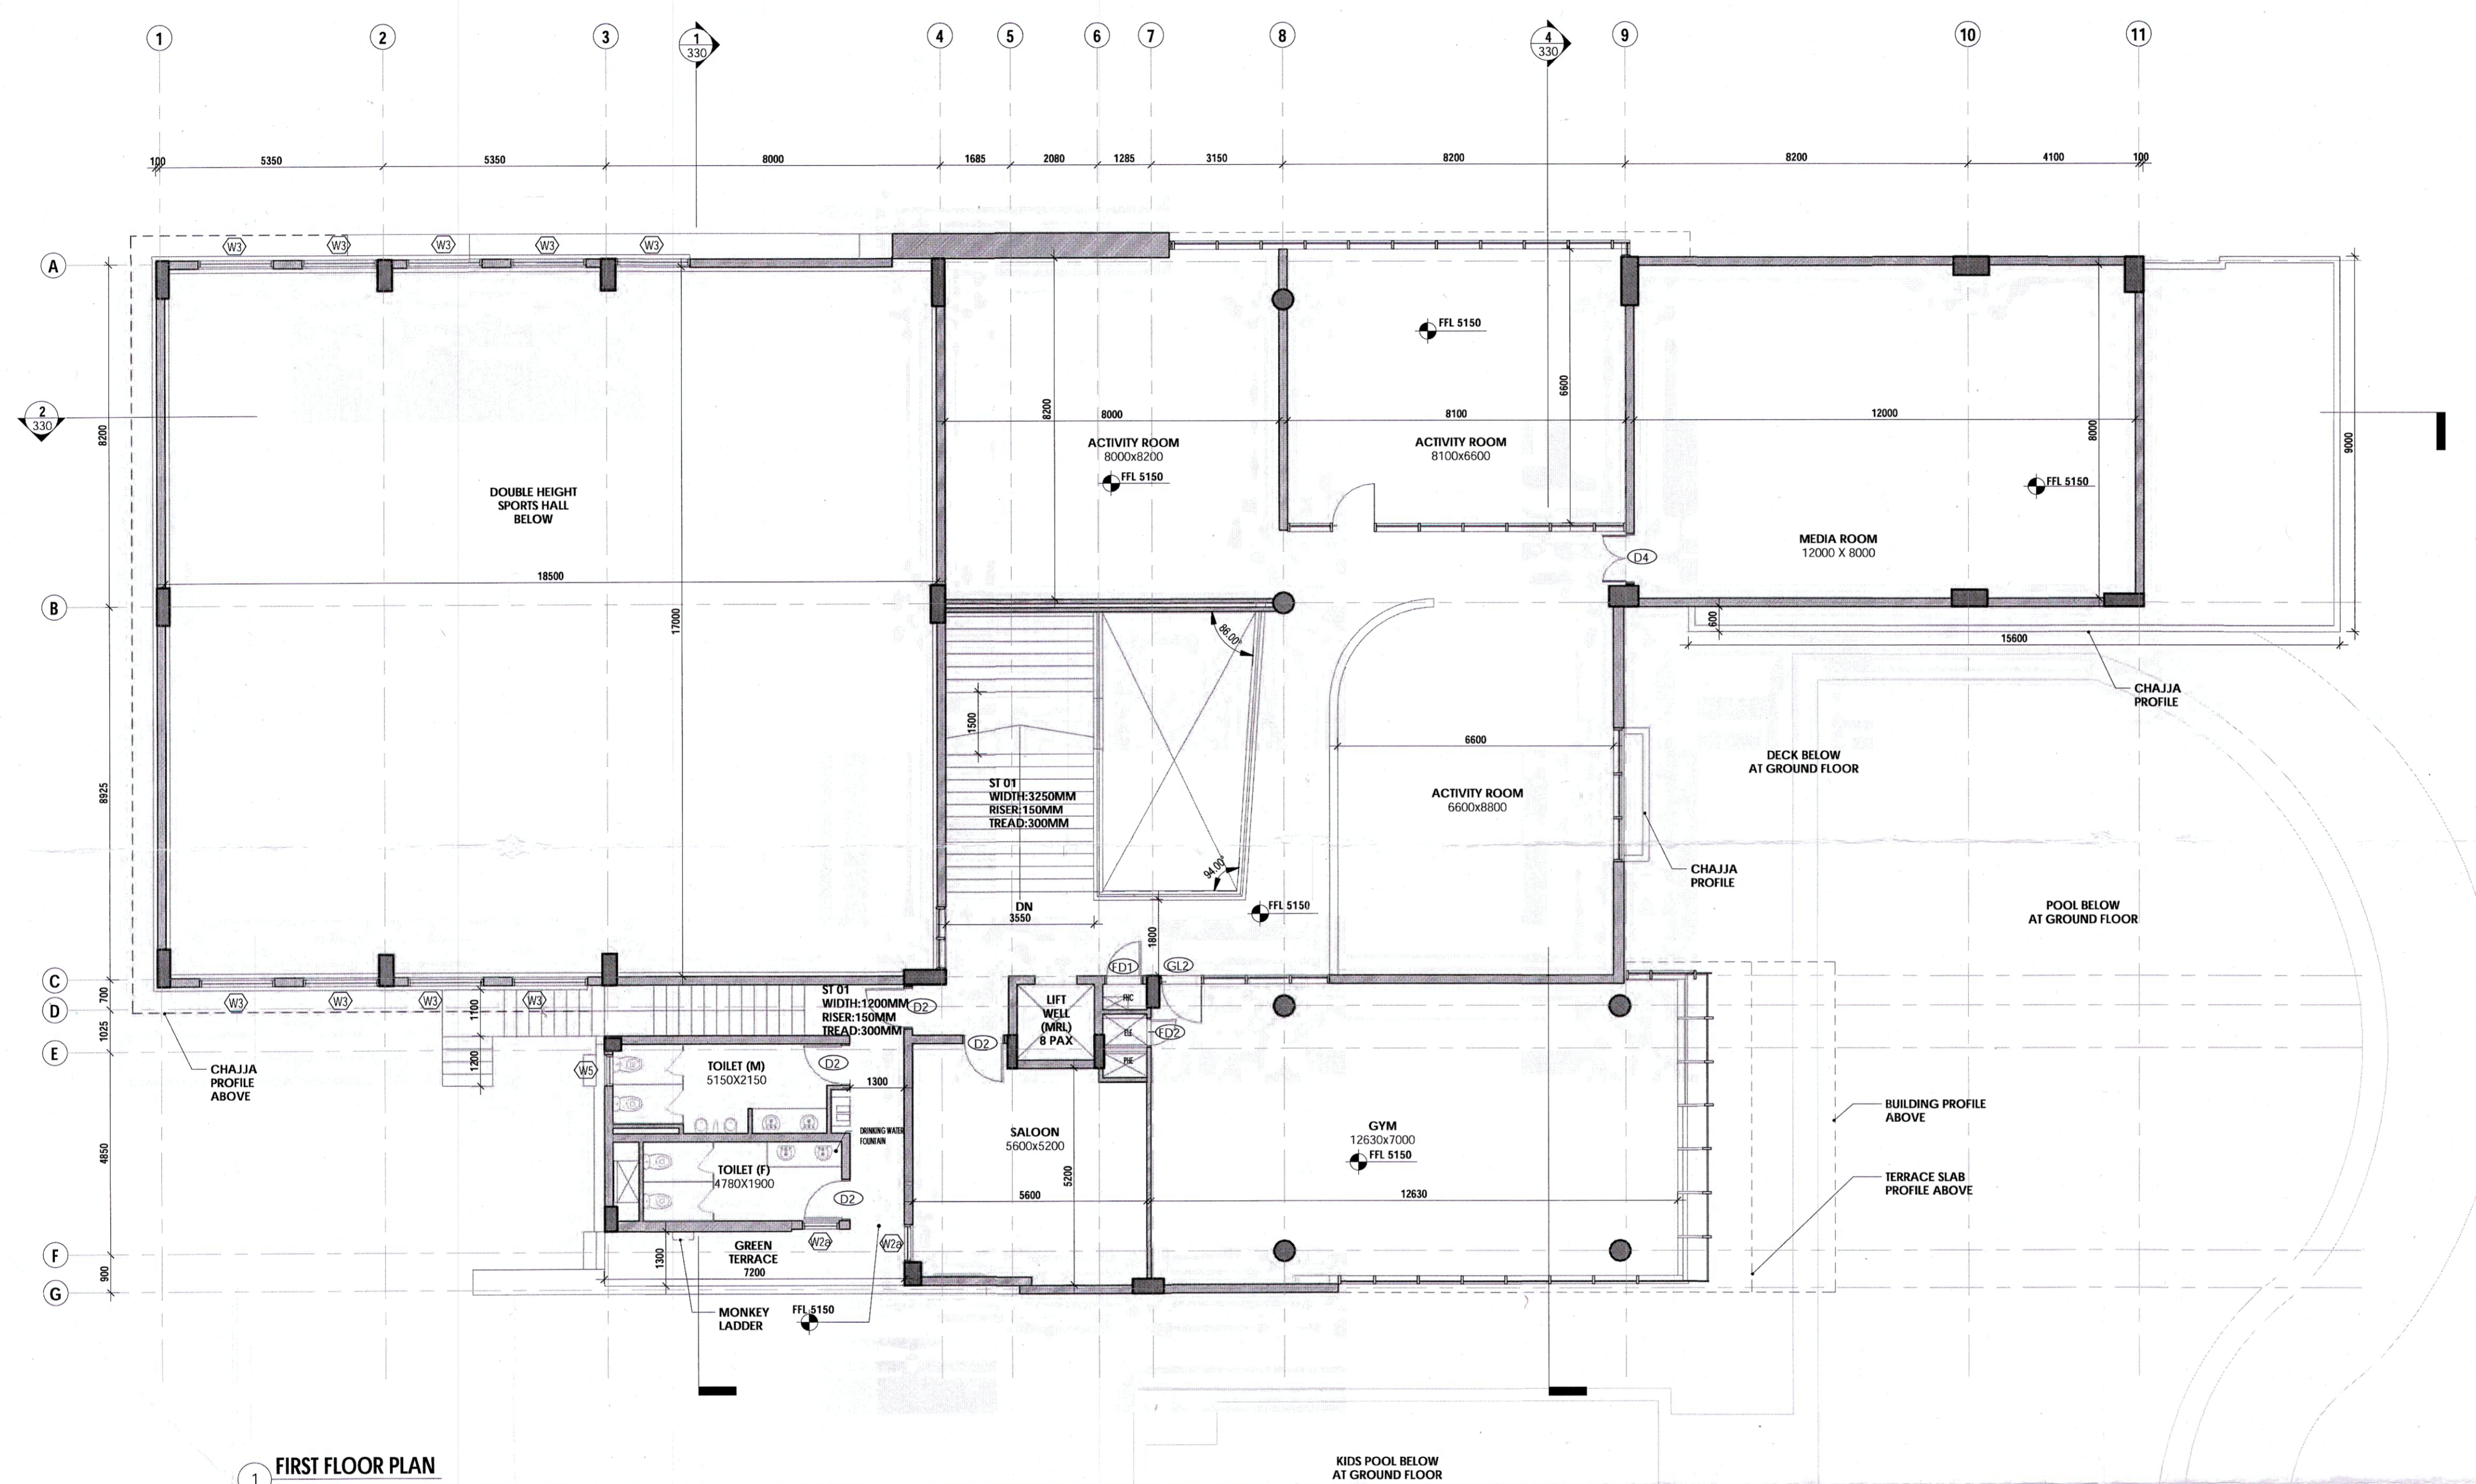

1 FIRST FLOOR PLAN
 1:100

Client/Developer
ASHIANA HOUSING LIMITED

Architect
BIAS ARCHITECTURE
 Bias+ Architecture
 601, Tower No. 24, Commonwealth Games Village, New Delhi 110 092
 Phone +91 11 48059233
 Email projects@biasarchitecture.com

MEP Consultant
 V.S. Kukreja & Associates Pvt. Ltd.
 165-A, Gautham Nagar
 New Delhi 110049

Structure Consultant
 Civtect consultants Pvt. Ltd.
 A-45, Sector 04
 Noida (UP) 201301
 Phone +91 120 4131184

Electrical Consultant
 V.S. Kukreja & Associates Pvt. Ltd.
 165-A, Gautham Nagar
 New Delhi 110049


Fire Fighting Consultant
 V.S. Kukreja & Associates Pvt. Ltd.
 165-A, Gautham Nagar
 New Delhi 110049

Disclaimer
 Drawings and written material appearing herein constitute original and unpublished work of the Architect and may not be duplicated, used or disclosed without written consent of the Architect.

Drawing Status
AS BUILT DRAWINGS

Architect's Signature
ASHWINI PARASHAR
 CA/2003/32346

Client's Signature

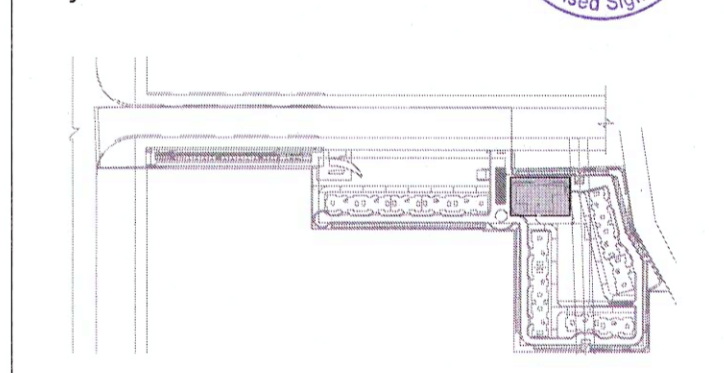

Project Name
AS BUILT BUILDING PLAN OF GROUP HOUSING SCHEME MEASURING 13.3375 ACRES (LICENCE NO. 20 OF 2014 DATED 11.06.2014) IN SECTOR-33, SOHNA BEING DEVELOPED BY ASHIANA HOUSING LIMITED (UNDER JOINT DEVELOPMENT AND MARKETING RIGHTS PERMISSION FROM DTCP)

Project Address
 Group Housing Project
 Sector 33
 Sohna, Haryana.

Drawing Title
COMMUNITY BUILDING FIRST FLOOR

Project No.	14.18.R
Scale	As indicated
Date	JAN 07, 2019
Drawing No	142