




JE
JD
ATP
DTP

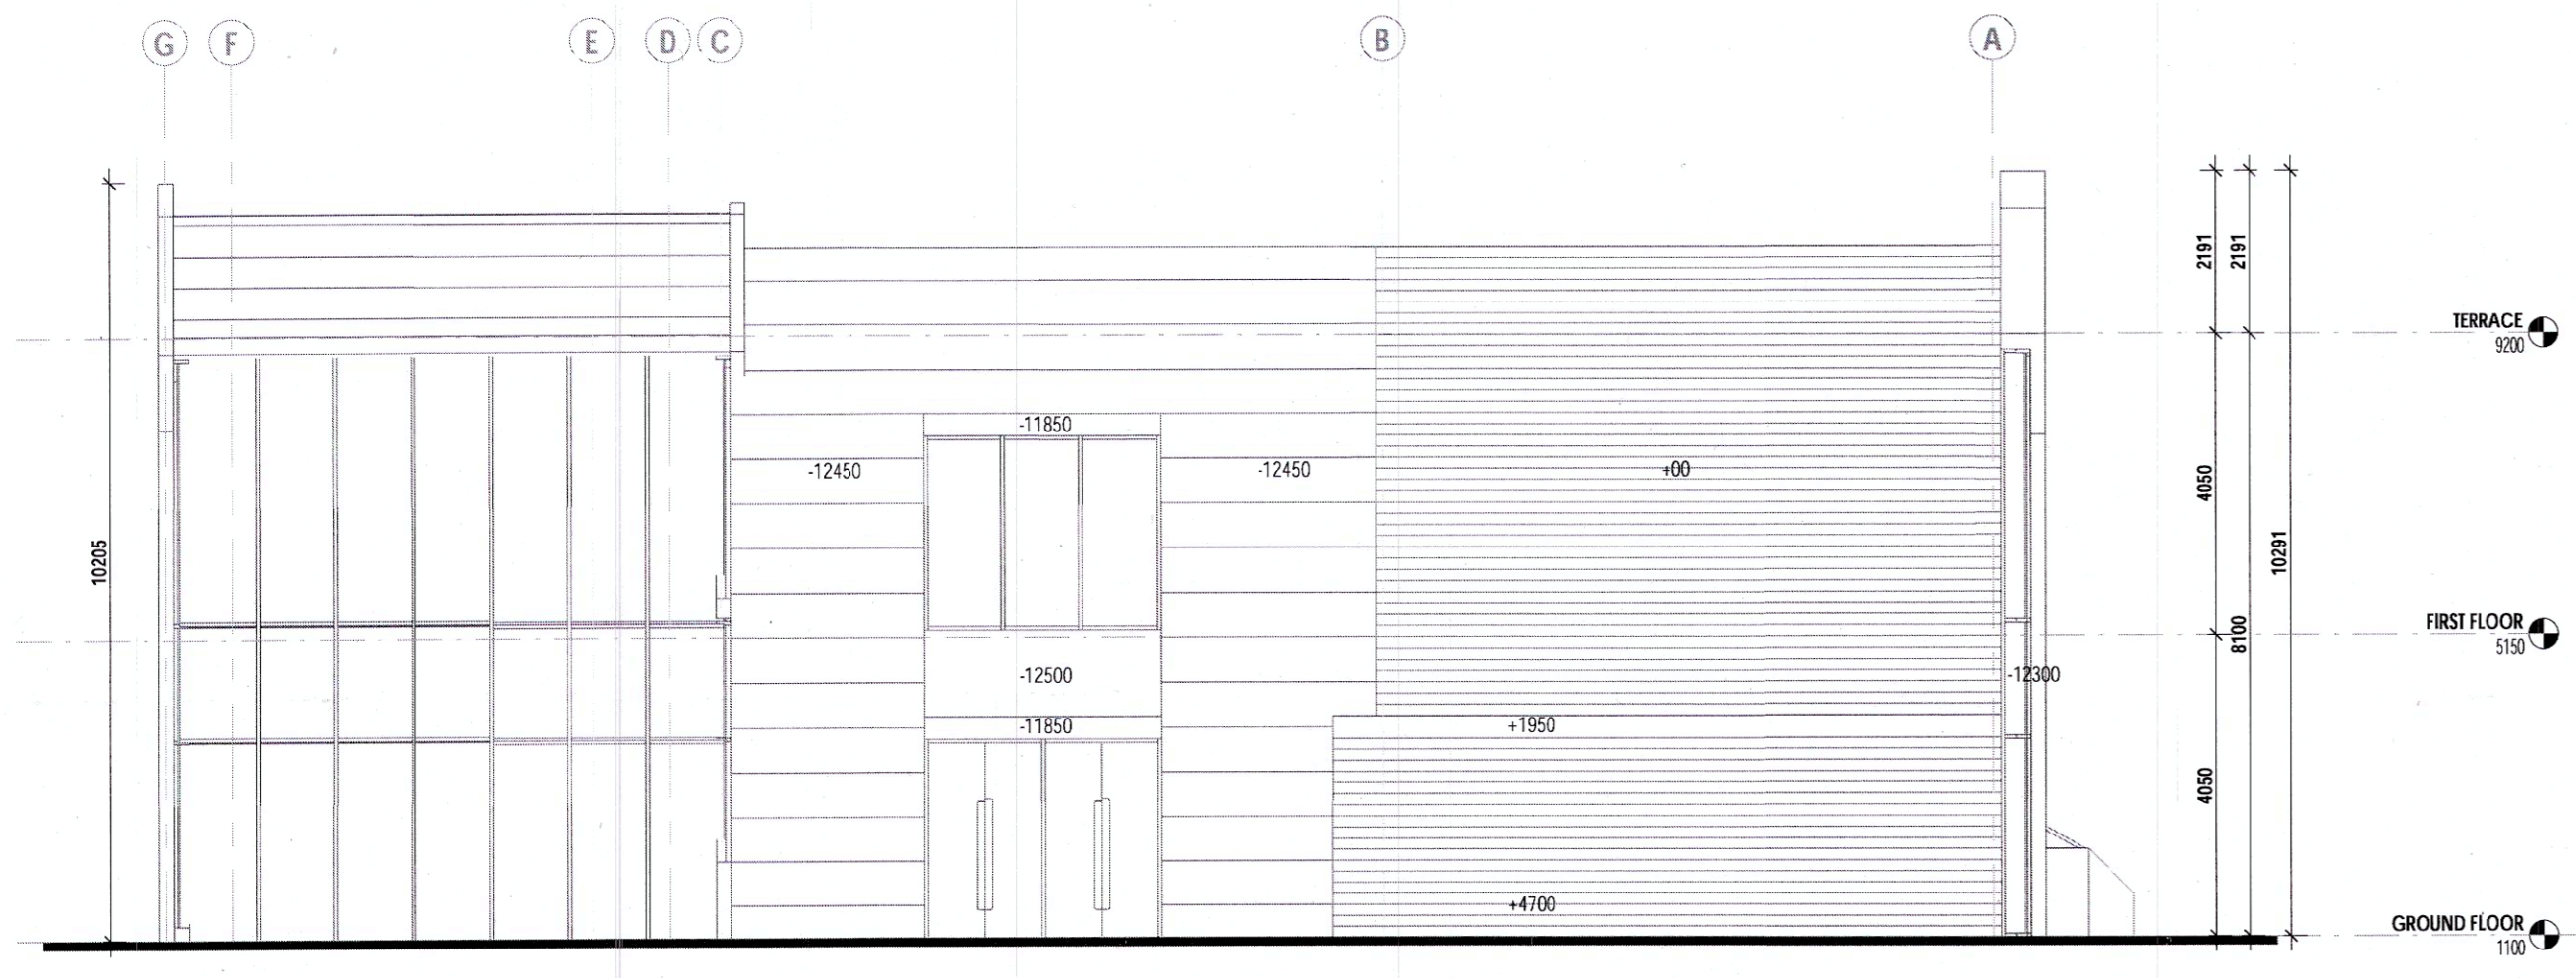


1 ELEVATION
1:100

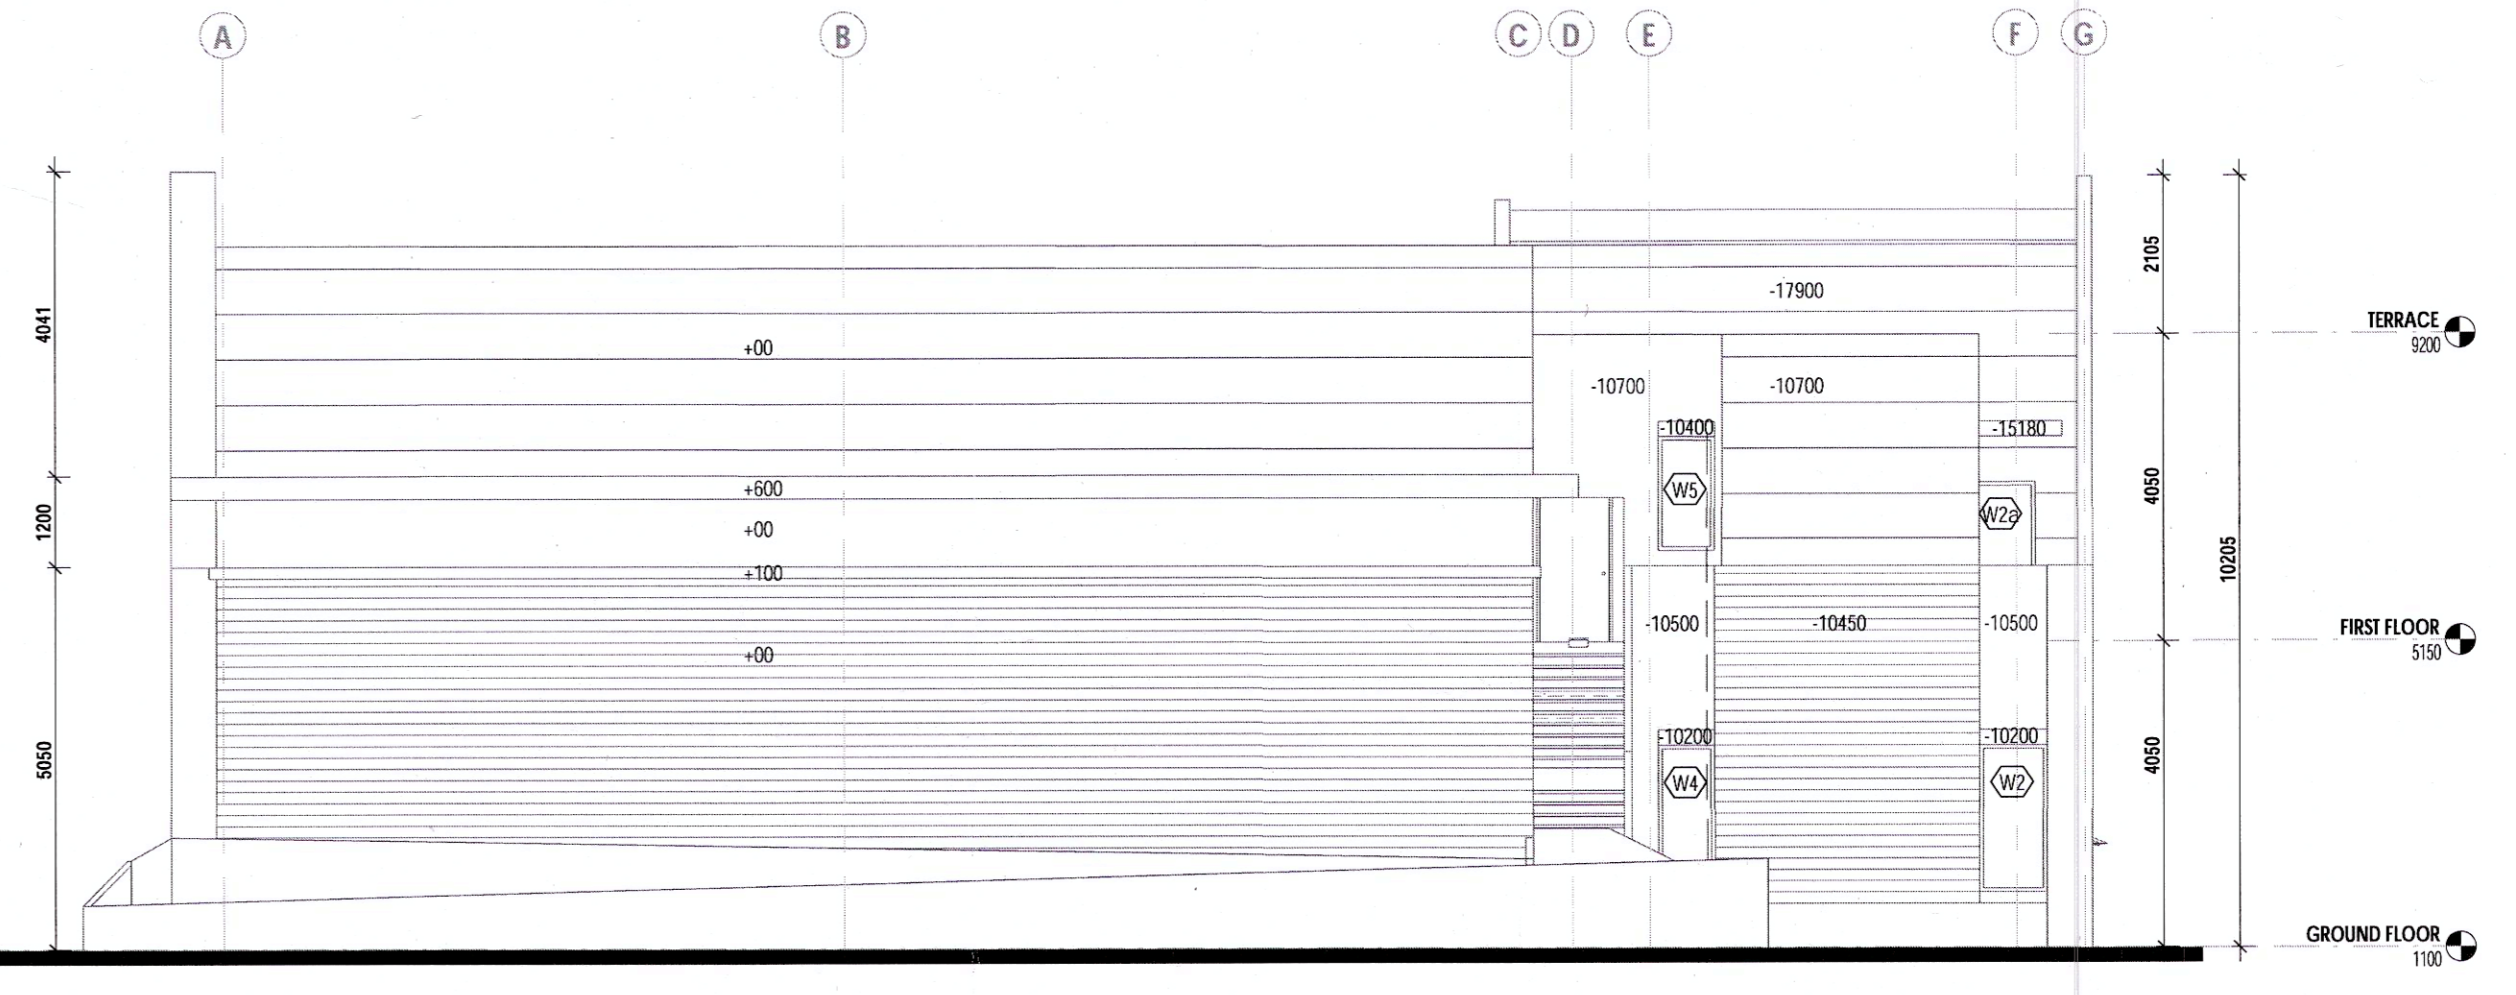

3 ELEVATION
1:100

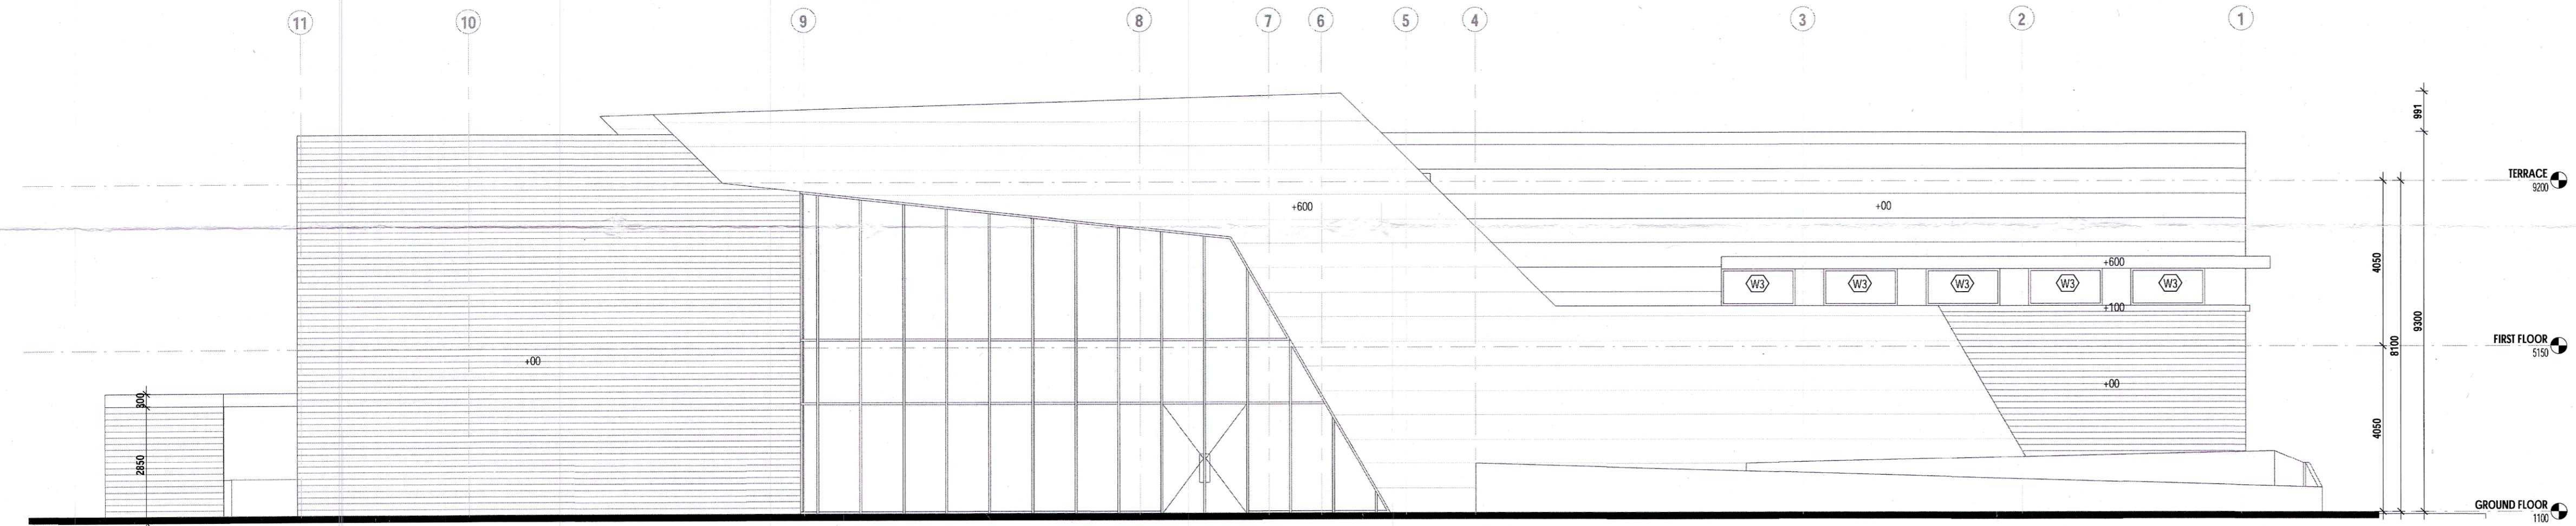

2 ELEVATION
1:100

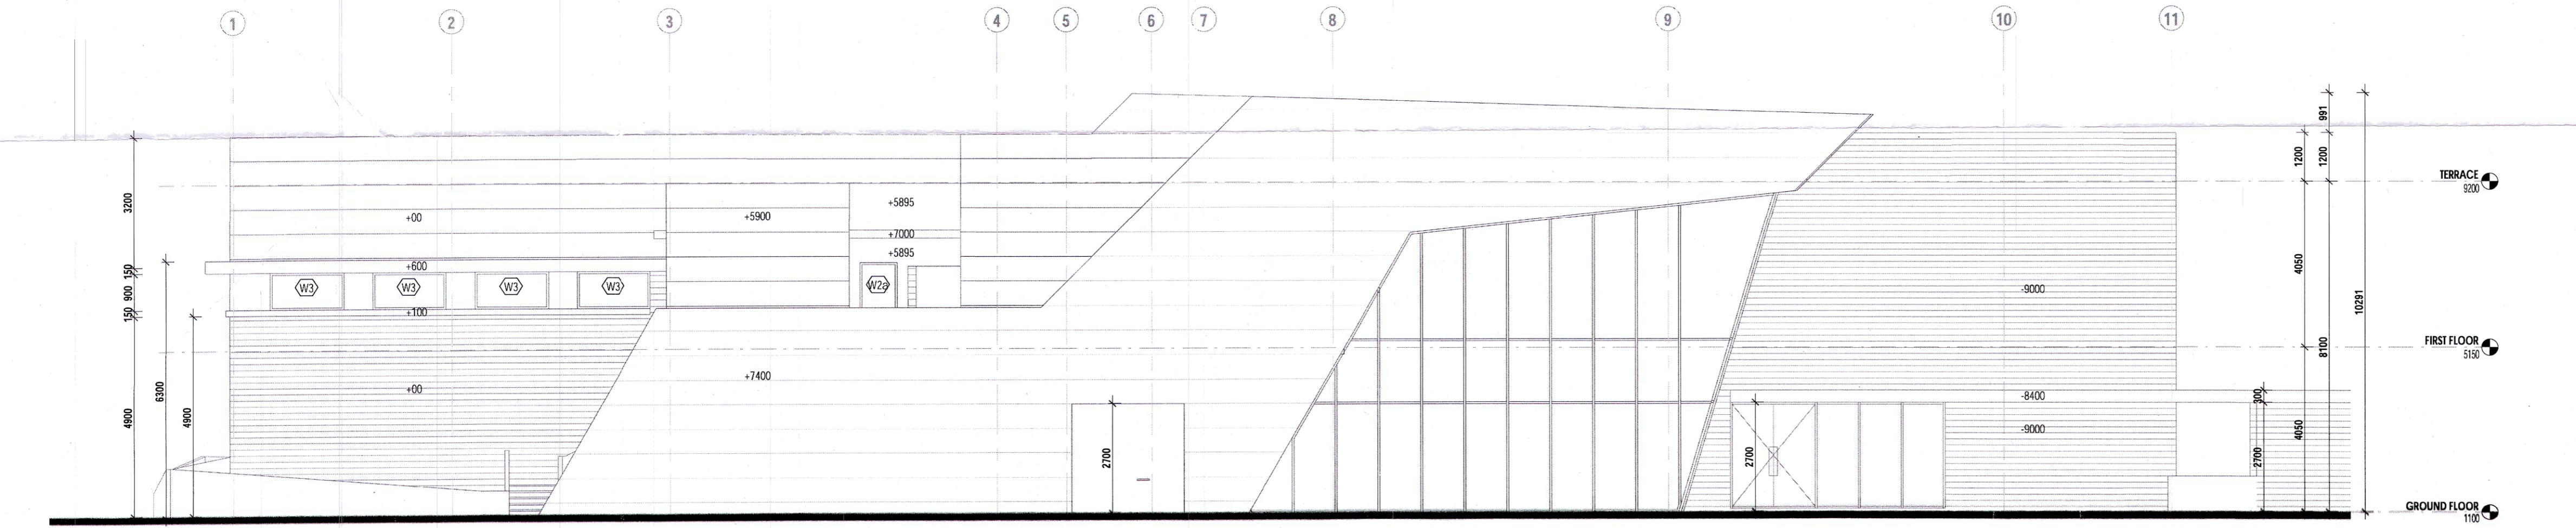

4 ELEVATION
1:100

Client/Developer
ASHIANA HOUSING LIMITED

Architect
BIAS ARCHITECTURE
Bias + Architecture
601, Tower No. 24, Commonwealth Games Village, New Delhi 110 092
Phone +91 11 46092933
Email projects@biasarchitecture.com


MEP Consultant V.S.Kukreja & Associates Pvt. Ltd 165-A, Gautham Nagar New Delhi 110049	Structure Consultant Civict consultants pvt. ltd A-45, Sector 04 Noida (UP) 201301 Phone +91 120 4131184
Electrical Consultant V.S.Kukreja & Associates Pvt. Ltd 165-A, Gautham Nagar New Delhi 110049	Fire Fighting Consultant V.S.Kukreja & Associates Pvt. Ltd 165-A, Gautham Nagar New Delhi 110049

Disclaimer
Drawings and written material appearing herein constitute original and unpublished work of the Architect and may not be duplicated, used or disclosed without written consent of the Architect.

AS BUILT DRAWINGS

Architect's Signature
ASHWINI PARASHAR
CA/2003/32346

Client's Signature
ASHIANA HOUSING LIMITED

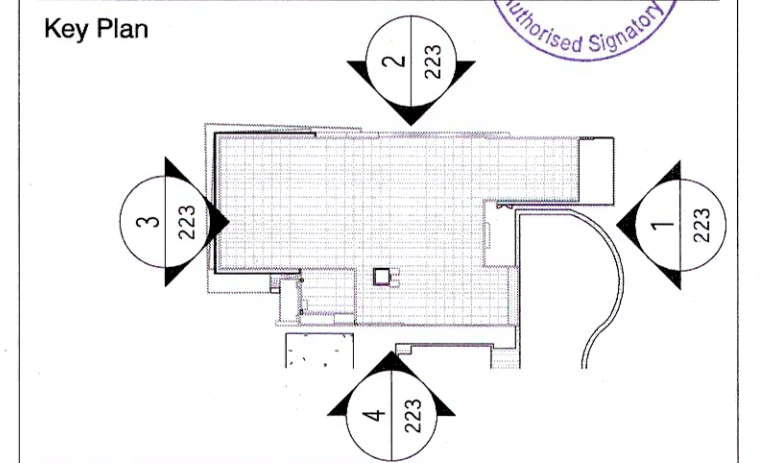

Project Name
AS BUILT BUILDING PLAN OF GROUP HOUSING SCHEME MEASURING 13.3375 ACRES (LICENCE NO. 20 OF 2014 DATED 11.06.2014) IN SECTOR-33, SOHNA BEING DEVELOPED BY ASHIANA HOUSING LIMITED (UNDER JOINT DEVELOPMENT AND MARKETING RIGHTS PERMISSION FROM DTCP)

Project Address
Group Housing Project
Sector 33
Sohna, Haryana.

Drawing Title
COMMUNITY BUILDING
ELEVATIONS

Project No.	14.18.R
Scale	As indicated
Date	JAN 07, 2019
Drawing No	223