


DOOR SCHEDULE			
TYPE MARK	WIDTH	HEIGHT	HEAD HEIGHT
D1	800	2400	2400
D2	900	2100	2100
F1	750	1500	1500
F2	800	1200	1800
F3	800	1200	1800
F4	800	1200	1800
F100	800	1200	1800

NURSERY SCHOOL / LEARNING CENTER AREA CALCULATIONS									
AREA OF RECTANGLE		BLOCK 01		BLOCK 02		BLOCK 03		BLOCK 04	
DEDUCTION	LENGTH	BREADTH	NUMBER	AREA (sqm)	DEDUCTION	LENGTH	BREADTH	NUMBER	AREA (sqm)
A	1.840	X	0.620	X	1.141	X	1.751	X	1.982
B	4.955	X	0.697	X	1.711	X	1.751	X	1.982
C	8.414	X	0.716	X	1.826	X	1.751	X	1.982
D	8.414	X	0.716	X	1.826	X	1.751	X	1.982
E	1.460	X	3.250	X	4.750	X	1.751	X	1.982
F	3.924	X	1.480	X	5.806	X	1.751	X	1.982
G	0.951	X	1.595	X	1.516	X	1.751	X	1.982
H	0.943	X	1.725	X	1.627	X	1.751	X	1.982
I	2.416	X	6.070	X	14.567	X	1.751	X	1.982
J	7.195	X	2.176	X	15.657	X	1.751	X	1.982
K	3.797	X	1.543	X	5.857	X	1.751	X	1.982
L	3.797	X	2.252	X	8.541	X	1.751	X	1.982
M	4.025	X	2.182	X	8.784	X	1.751	X	1.982
N	4.025	X	3.151	X	12.684	X	1.751	X	1.982
O	6.025	X	3.151	X	19.184	X	1.751	X	1.982
P	5.025	X	3.151	X	15.934	X	1.751	X	1.982
TOTAL DEDUCTION				10.786	21.893				
BLOCK 01 TOTAL				21.893					
BLOCK 02 TOTAL				15.632					
BLOCK 03 TOTAL				1.005					
BLOCK 04 TOTAL				1.325					
TOTAL FAR ON GROUND FLOOR				32.294					
TOTAL FAR ON GROUND FLOOR				203.879					
TOTAL GROUND COVERAGE				203.879					
GROUND FLOOR AREA				203.879					
AREA OF SITE				0.22 ACRES					
PERMISSIBLE GROUND COVERAGE @ 33.33%				809.37					
PERMISSIBLE FAR @ 1				809.37					
PROPOSED GROUND COVERAGE				203.879					
FAR ON GROUND FLOOR				203.879					

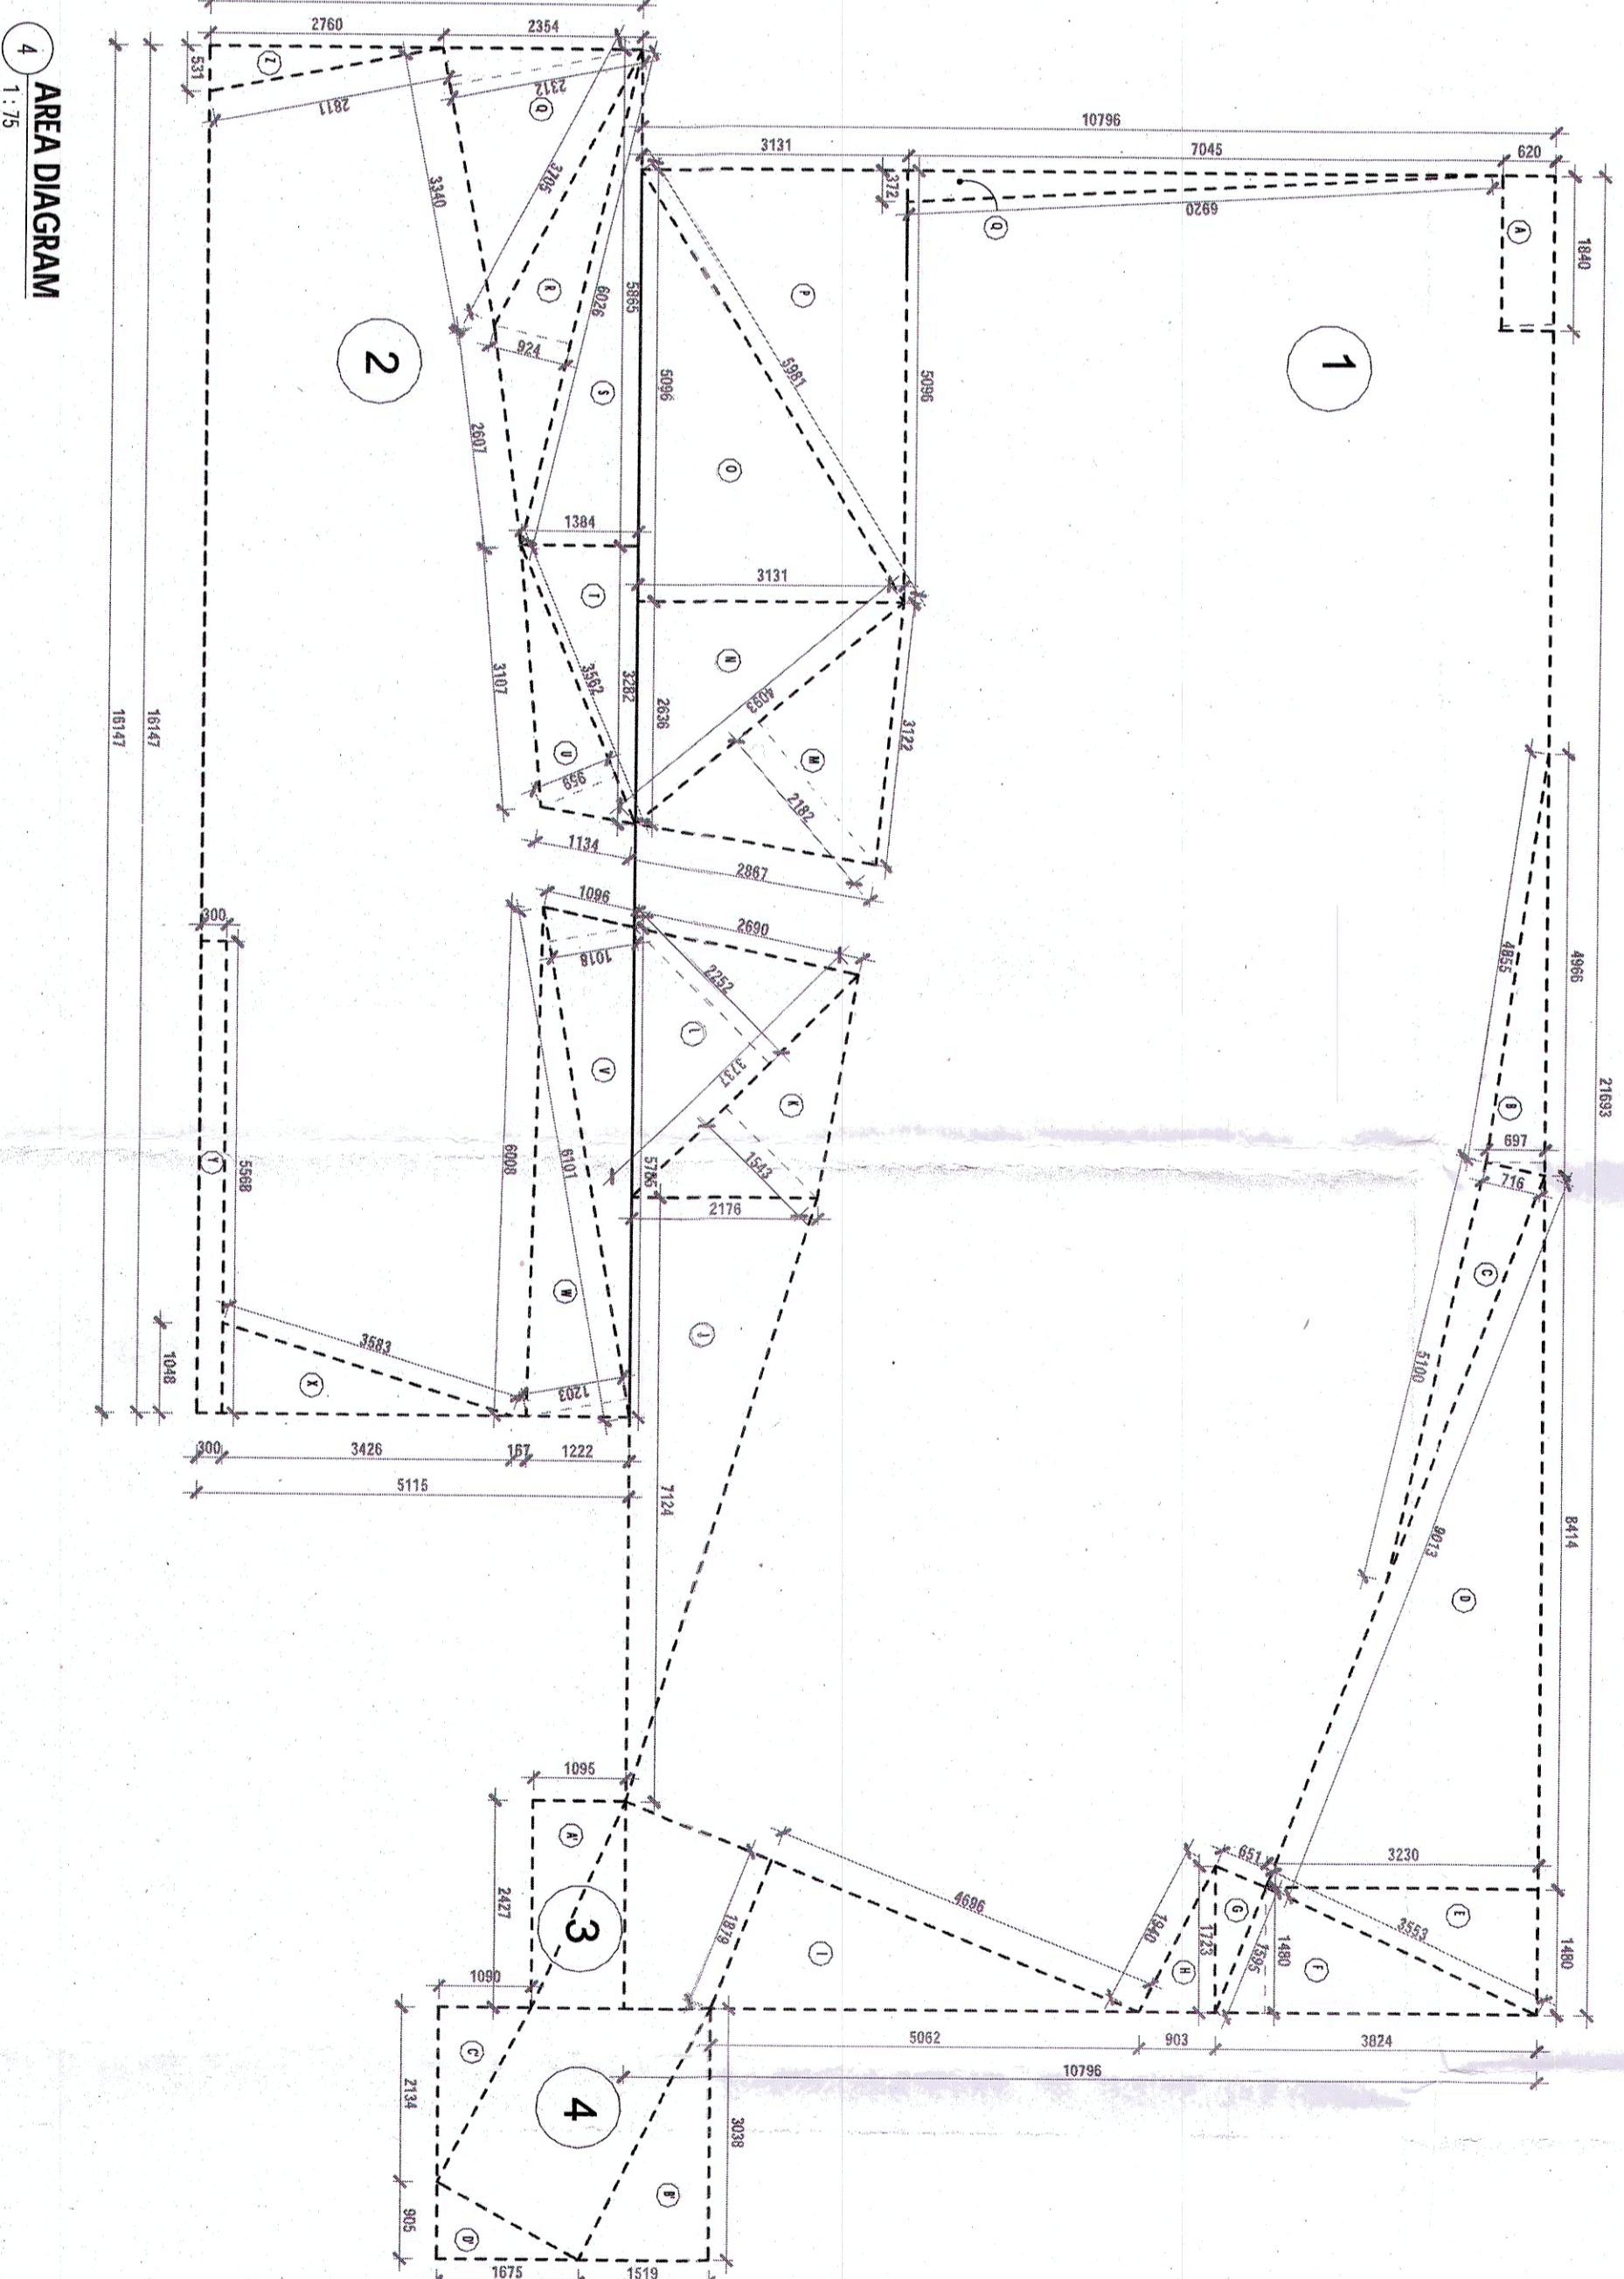

DE
 SP
 AT
 DP

AS BUILT DRAWING
 Client/Developer: **ASHAMA HOUSING LIMITED**
 Architect: **BIAS ARCHITECTS**
 Project Name: **NURSERY SCHOOL / LEARNING CENTER FLOOR PLANS**
 Date: **11/20/2013**
 Scale: **1:100**
 Drawing No: **132**