DOOR SCHEDULE				
TYPE MARK	WIDTH	HEIGHT	SILL HEIGHT	LINTEL HEIGHT
D1	900	2100	0	2100
D2	1000	2100	0	2100
D3	750	2100	0	2100
D4	1200	2700	0	2700
D5	1500	2700	0	2700
D6	1050	2100	0	2100
FD1	900	1600	500	2100
FD2	700	1600	500	2100

WINDOW SCHEDULE				
TYPE MARK	WIDTH	HEIGHT	SILL HEIGHT	LINTEL HEIGHT
W1	900	750	2700	3450
W2	900	1950	750	2700
W2a	900	1950	150	2100
W3	1800	900	1000	1900
W4	750	1950	750	2700
W5	750	1500	1200	2700

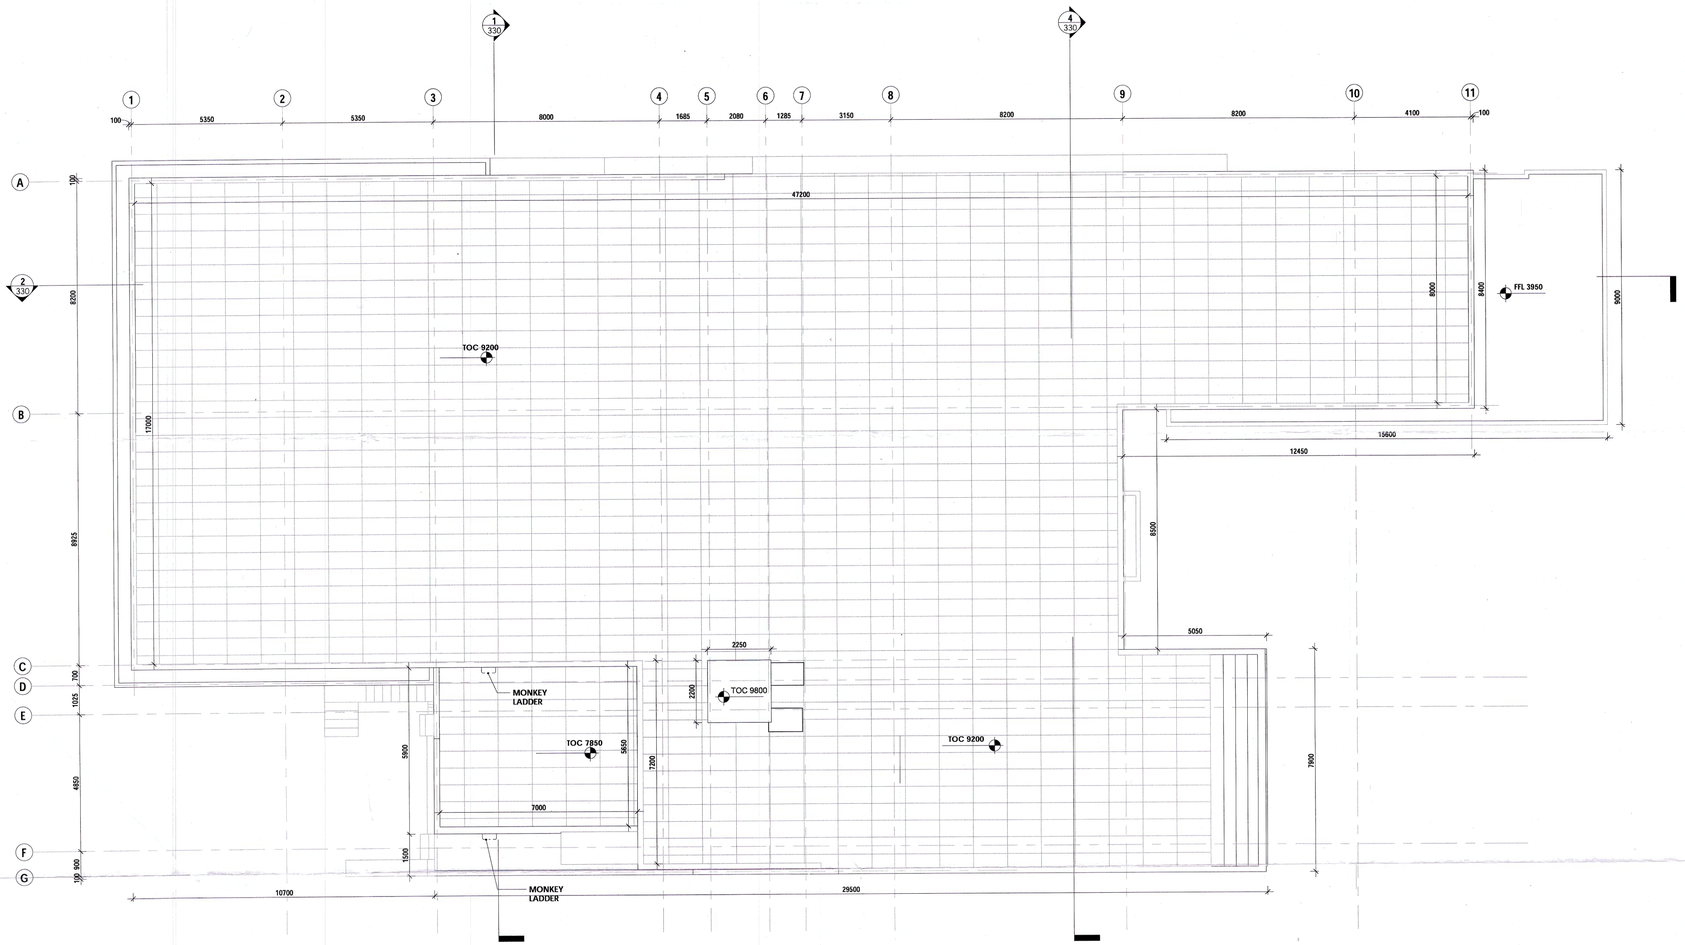

1 **TERRACE**
1 : 100

JE
JD
ATP
DTP

Client/Developer

ASHIANA HOUSING LIMITED

Architect

BIAS ARCHITECTURE

Bias+ Architecture
601, Tower No. 24, Commonwealth Games Village, New Delhi 110 092
Phone +91 11 49050933
Email projects@biasarchitecture.com

MEP Consultant
V.S.Kukreja & Associates Pvt. Ltd
165-A, Gautham Nagar
New Delhi 110049

Structure Consultant
Civtect consultants pvt. ltd
A-45, Sector 04
Noida (UP) 201301
Phone +91 120 4131184

Electrical Consultant
V.S.Kukreja & Associates Pvt. Ltd
165-A, Gautham Nagar
New Delhi 110049

Fire Fighting Consultant
V.S.Kukreja & Associates Pvt. Ltd
165-A, Gautham Nagar
New Delhi 110049

Disclaimer

Drawings and written material appearing herein constitute original and unpublished work of the Architect and may not be duplicated, used or disclosed without written consent of the Architect.

Drawing Status

AS BUILT DRAWINGS

Architect's Signature

ASHWINI PARASHAR
CA /2003/32346

Client's Signature

ASHIANA HOUSING LTD Authorised Signatory

Key Plan

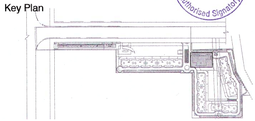

Project Name

AS BUILT BUILDING PLAN OF GROUP HOUSING SCHEME MEASURING 13.3375 ACRES (LICENCE NO. 20 OF 2014 DATED 11.06.2014) IN SECTOR-33, SOHNA BEING DEVELOPED BY ASHIANA HOUSING LIMITED (UNDER JOINT DEVELOPMENT AND MARKETING RIGHTS PERMISSSION FROM DTCP)

Project Address
Group Housing Project
Sector 33
Sohna, Haryana.

Drawing Title
COMMUNITY BUILDING TERRACE PLAN

Project No.	14.18.R
Scale	As indicated
Date	JAN 07, 2019
Drawing No	143